GRANT COUNTY

Survey Monument Record

CORNER NO. 71
SECTION 17
TOWN 5N
RANGE 3W
SW COR

TYPE OF MONUMENT GRANT CO. ALUMIN. MON.
STATE PLANE COORDINATES: N —
E —
ELEVATION — M.S.L. DATUM: —
THETA ANGLE: —
FIELD BOOK: 94-15
PAGE 22

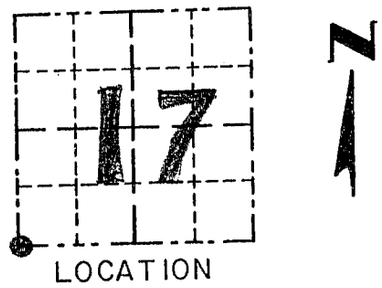

LOCATION
(Indicated by "●")

BASIS FOR MONUMENT LOCATION

(Use reverse side if necessary)

Show info such as: History of corner, with reference to Vol. and pg., dates, surveyor; exact description of monument replaced; if location computed, by taped or EDM traverse; landowner, remarks, etc.

NO RECORD FOUND OF CORNER SINCE THE ORIGINAL SURVEYS; I ACCEPTED OCCUPATION OF FENCE FOR N-S LOCATION & PROPORTIONED IN E-W LOCATION TO S1/4 CORNER OF SEC. 18 & S1/4 COR. OF SEC. 17 THIS LOCATION FITS WELL WITH "46" CORNER TO THE NORTH & OLD FENCE REMNANTS TO THE SOUTH.

SEAL:

WISCONSIN
LARRY L. AUSTIN
S-1203
LANCASTER
WI
LAND SURVEYOR

CERTIFIED CORRECT
Larry L. Austin
Registered Land Surveyor
DATE: 8/30/94

TIE SKETCH

Show at least three (3) ties and monument

LEGEND

● GRANT COUNTY ALUM. MON. SET
○ 3/4" IRON BAR SET
✕—✕ FENCE

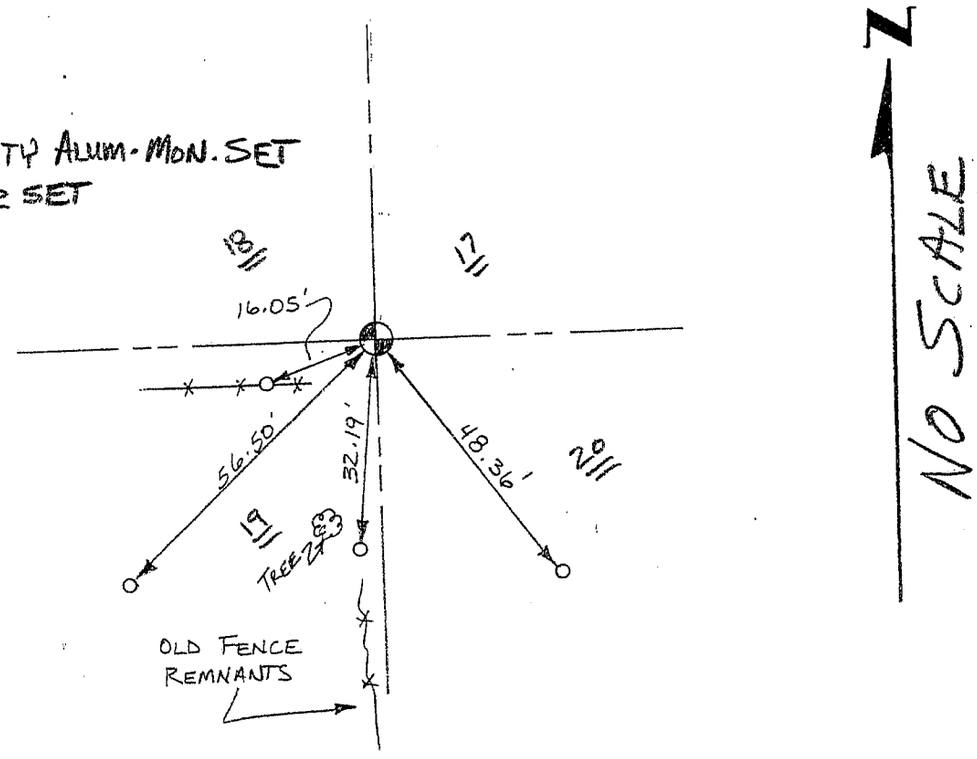

FORM LC 102

71