RECD JAN 29 1996

Survey Monument Record

CORNER NO. 89
SECTION 28
TOWN 5N
RANGE 3W

TYPE OF MONUMENT BASE 2" PIPE POST IN CONC.
STATE PLANE COORDINATES: N
E
ELEVATION — M.S.L. DATUM:
THETA ANGLE:
FIELD BOOK: 95-10
PAGE 24

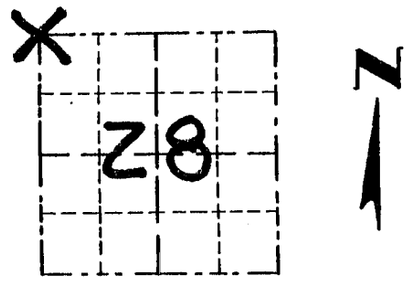

LOCATION
(Indicated by "X")

BASIS FOR MONUMENT LOCATION

(Use reverse side if necessary)

2" IRON PIPE POST FOUND AND ACCEPTED AT THE OCCUPIED FENCE CORNER AND VERIFIED BY EDM TRAVERSE OF THE AREA

SEAL:

CERTIFIED CORRECT
Larry L. Rust
Registered Land Surveyor
DATE: 1/19/96

TIE SKETCH

Show at least three (3) ties and monument

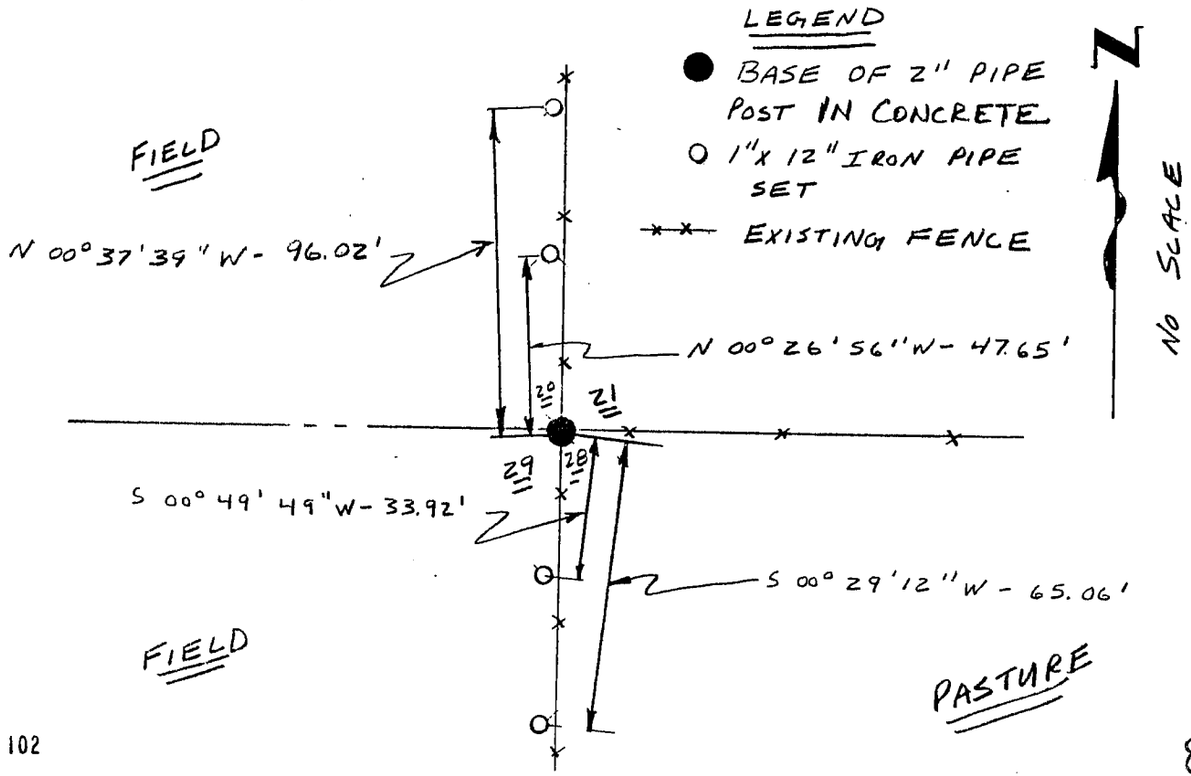

FORM LC 102