U.S. PUBLIC LAND SURVEY MONUMENT RECORD

Section 36, Town 5 North Range 3 West, Town of North Lancaster, Grant County, Wisconsin

CERTIFICATE

I, Larry L. Austin, do hereby certify that the corner location on this record was determined by me and/or under my direct supervision and that this U.S. public land survey monument record is correct and complete to the best of my knowledge and belief.

Larry L. Austin, S-1903 date 1-4-07

WISCONSIN LARRY L. AUSTIN S-1903 LAND SURVEYOR

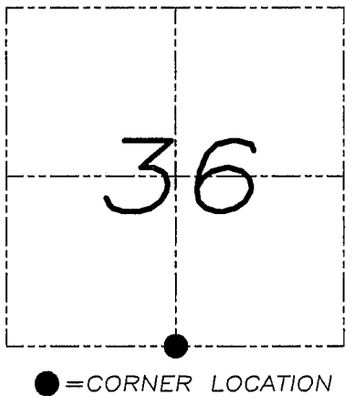

HISTORY OF CORNER

Corner was originally set by Lyon. In 1842 Freeman tied to the corner. In 1844 Wiltse tied to the corner. No other record of the corner was found.

CORNER EVIDENCE FOUND

I found no evidence of the original or subsequent survey corner. I found and accepted an occupied location after an EDM & GPS traverse of the area.

DESCRIPTION OF CORNER AND WITNESS MONUMENTS, references and accessories used to perpetuate the original or re-established location of this corner. Witnesses to monument location Bobby Sedgwick & Brad Digman & Shane Austin

SKETCH:

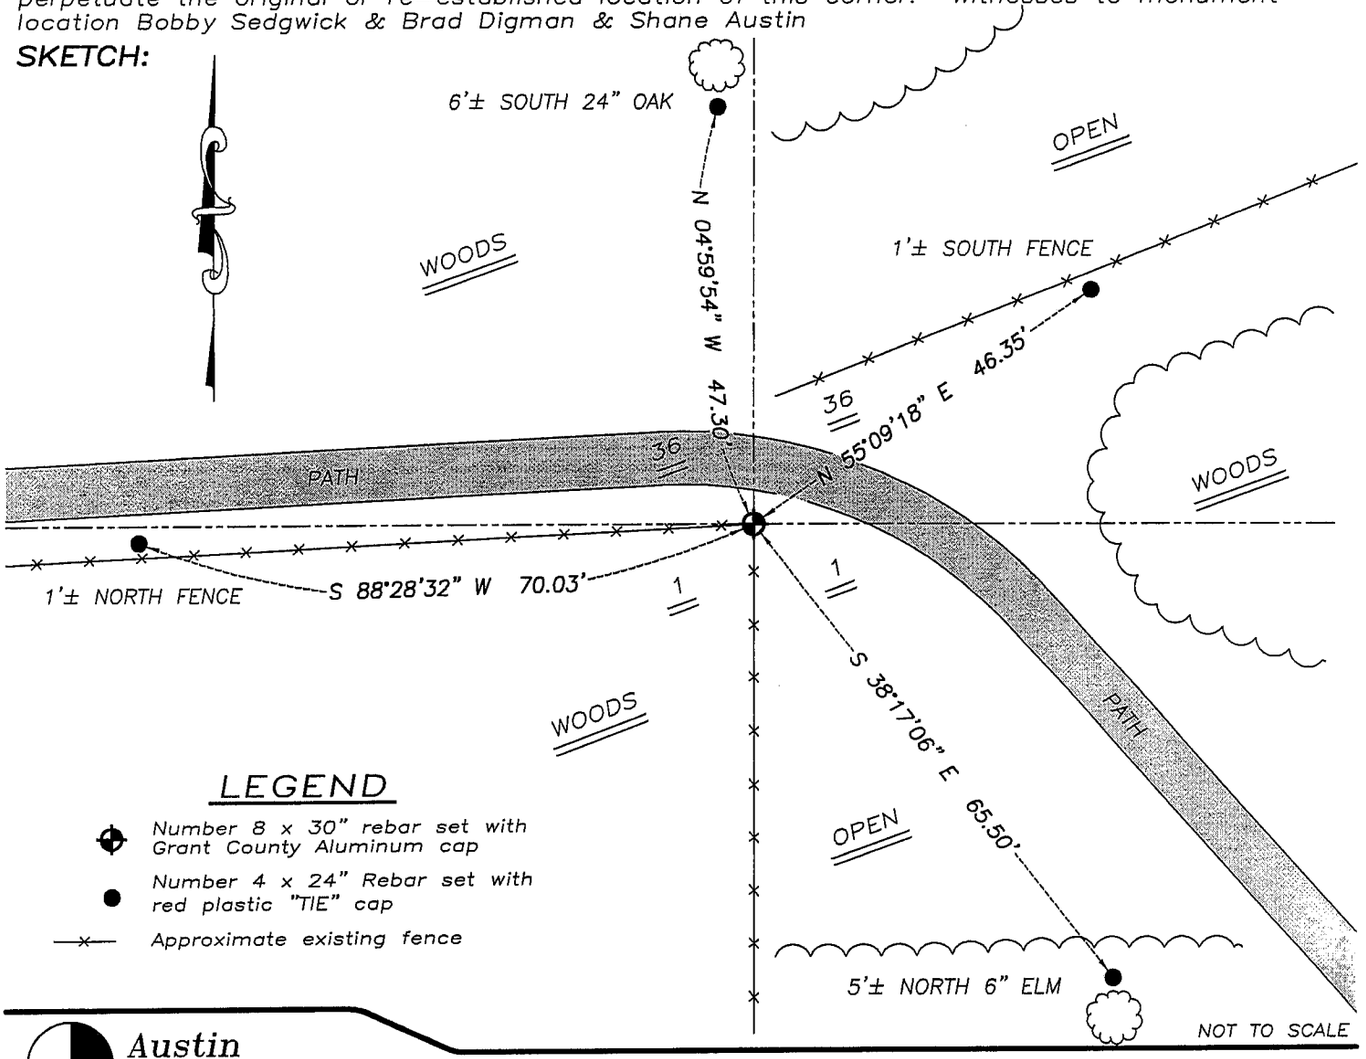

LEGEND

- Number 8 x 30" rebar set with Grant County Aluminum cap
- Number 4 x 24" Rebar set with red plastic "TIE" cap
- Approximate existing fence

Austin Engineering LLC
4211 HWY 81 E, LANCASTER, WI 53813
PHONE 608-723-6363 FAX 608-723-6702

JOB NUMBER 07S215
FIELDBOOK: TDSR, 2700
G:\T5NR2W\32
H:\TIE\T5NR3W\122

DRAWN BY: SW AUSTIN
APPROVED: LL AUSTIN

122