U.S. PUBLIC LAND SURVEY MONUMENT RECORD

Section 4, Town 6 North Range 1 West, Town of Wingsville, Grant County, Wisconsin

CERTIFICATE

I, Larry L. Austin, do hereby certify that the corner location on this record was determined by me and/or under my direct supervision and that this U.S. public land survey monument record is correct and complete to the best of my knowledge and belief.

WISCONSIN LARRY L. AUSTIN S-1903 LANCASTER WI LAND SURVEYOR

Larry L. Austin — 10.15.08 date

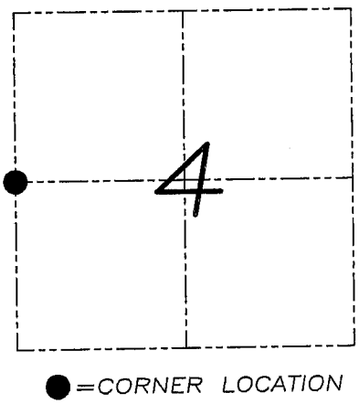

HISTORY OF CORNER

Corner was originally set in the first quarter of 1832. No other record of the corner was found.

CORNER EVIDENCE FOUND

Northing was established proportionately between the Northwest and Southwest corners. Existing fence was used for Easting. Verified this location using EDM & GPS methods.

DESCRIPTION OF CORNER AND WITNESS MONUMENTS, references and accessories used to perpetuate the original or re-established location of this corner. Witnesses to monument location Bobby Sedgwick & Brad Digman & Shane Austin

SKETCH:

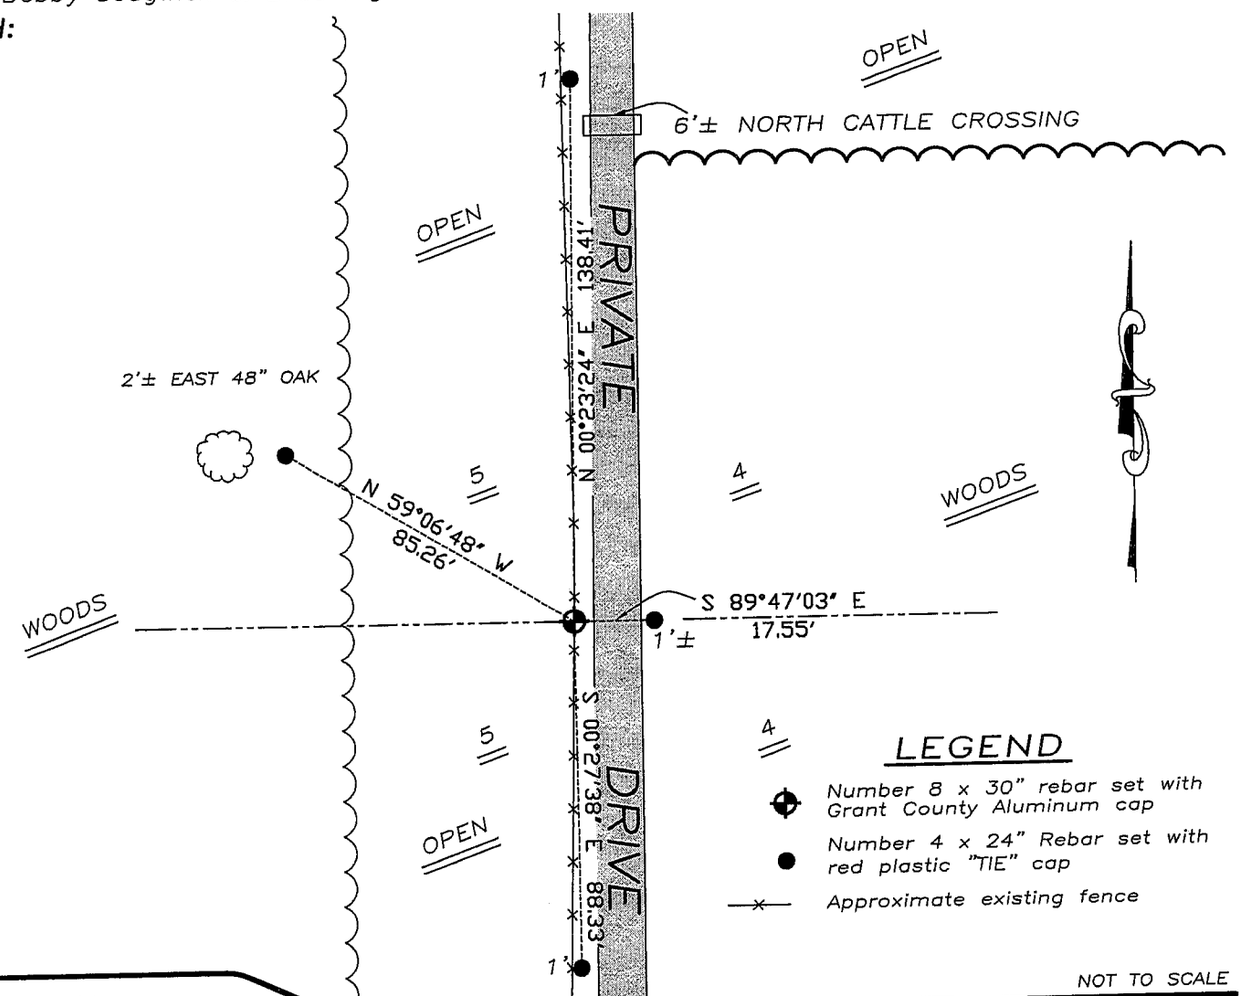

Austin Engineering LLC
4211 HWY 81 E, LANCASTER, WI 53813
PHONE 608-723-6363 FAX 608-723-6702

JOB NUMBER 07S339
FIELDBOOK: TDSR, 2800
G:\T7NR1W\29BS
H:\TIE\T6NR1W\16

DRAWN BY: BL STANFLEY
APPROVED: LL AUSTIN