U.S. PUBLIC LAND SURVEY MONUMENT RECORD

Section 9, Town 6 North Range 1 West, Town of Wingville, Grant County, Wisconsin

CERTIFICATE

I, Larry L. Austin, do hereby certify that the corner location on this record was determined by me and/or under my direct supervision and that this U.S. public land survey monument record is correct and complete to the best of my knowledge and belief.

WISCONSIN LARRY L. AUSTIN S-1911903 LANCASTER WI LAND SURVEYOR

Larry L. Austin, date 1.2.09

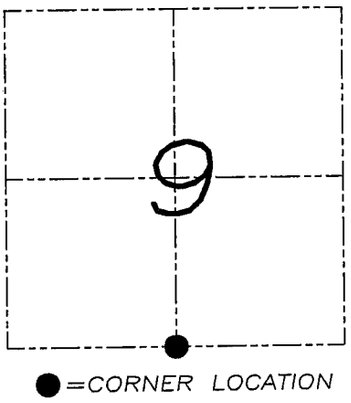

HISTORY OF CORNER

Corner was originally set in the first quarter of 1832 by Sibley. In 1882 J.C. Scott found a stone pile. No other record of the corner was found.

CORNER EVIDENCE FOUND

I was unable to locate the stone pile due to recent fence clearing. I reset the corner proportionately and on-line between the Southwest and Southeast corners. Verified this location using EDM & GPS methods.

DESCRIPTION OF CORNER AND WITNESS MONUMENTS, references and accessories used to perpetuate the original or re-established location of this corner. Witnesses to monument location Bobby Sedgwick & Brad Digman & Shane Austin

SKETCH:

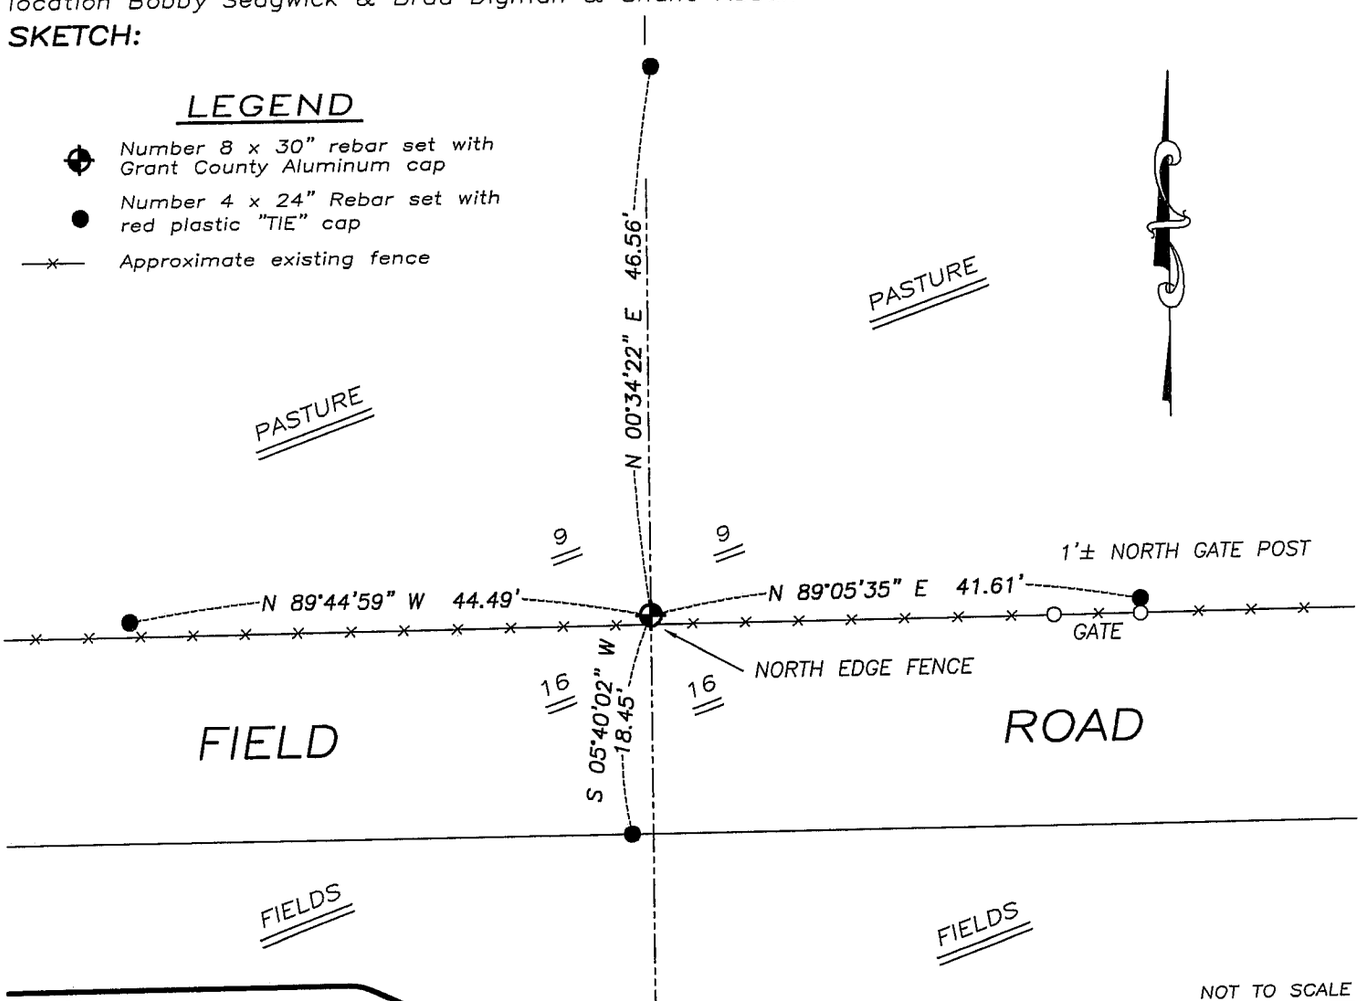

NOT TO SCALE

Austin Engineering LLC
4211 HWY 81 E, LANCASTER, WI 53813
PHONE 608-723-6363 FAX 608-723-6702

JOB NUMBER 08S265
FIELDBOOK: TDSR, 2803
G:\T7NR1W\29
H:\TIE\T6NR1W\48

DRAWN BY: SW AUSTIN
APPROVED: LL AUSTIN