U.S. PUBLIC LAND SURVEY MONUMENT RECORD

Section 29, Town 6 North Range 1 West, Town of Wingville, Grant County, Wisconsin

CERTIFICATE

I, Larry L. Austin, do hereby certify that the corner location on this record was determined by me and/or under my direct supervision and that this U.S. public land survey monument record is correct and complete to the best of my knowledge and belief.

WISCONSIN LARRY L. AUSTIN S-1903 LAND SURVEYOR

Larry L. Austin, SWI1903 — 11.25.08 date

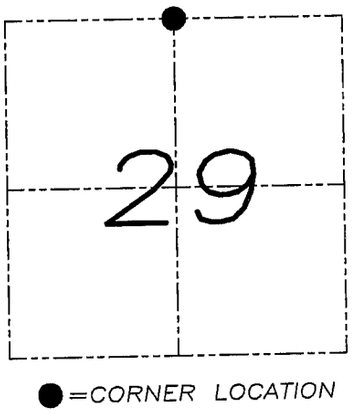

●=CORNER LOCATION

HISTORY OF CORNER

Corner was originally set in 1833 by Sibley. In 1846 Stuntz tied to the original corner. In 1870 Allen also tied to the corner. No other record of the corner was found.

CORNER EVIDENCE FOUND

I set the corner on-line between the Northwest and Northeast corners for Northing. Easting was established with existing fence South. Verified this location using EDM & GPS methods.

DESCRIPTION OF CORNER AND WITNESS MONUMENTS, references and accessories used to perpetuate the original or re-established location of this corner. Witnesses to monument location Bobby Sedgwick & Brad Digman & Shelby Blindert

SKETCH:

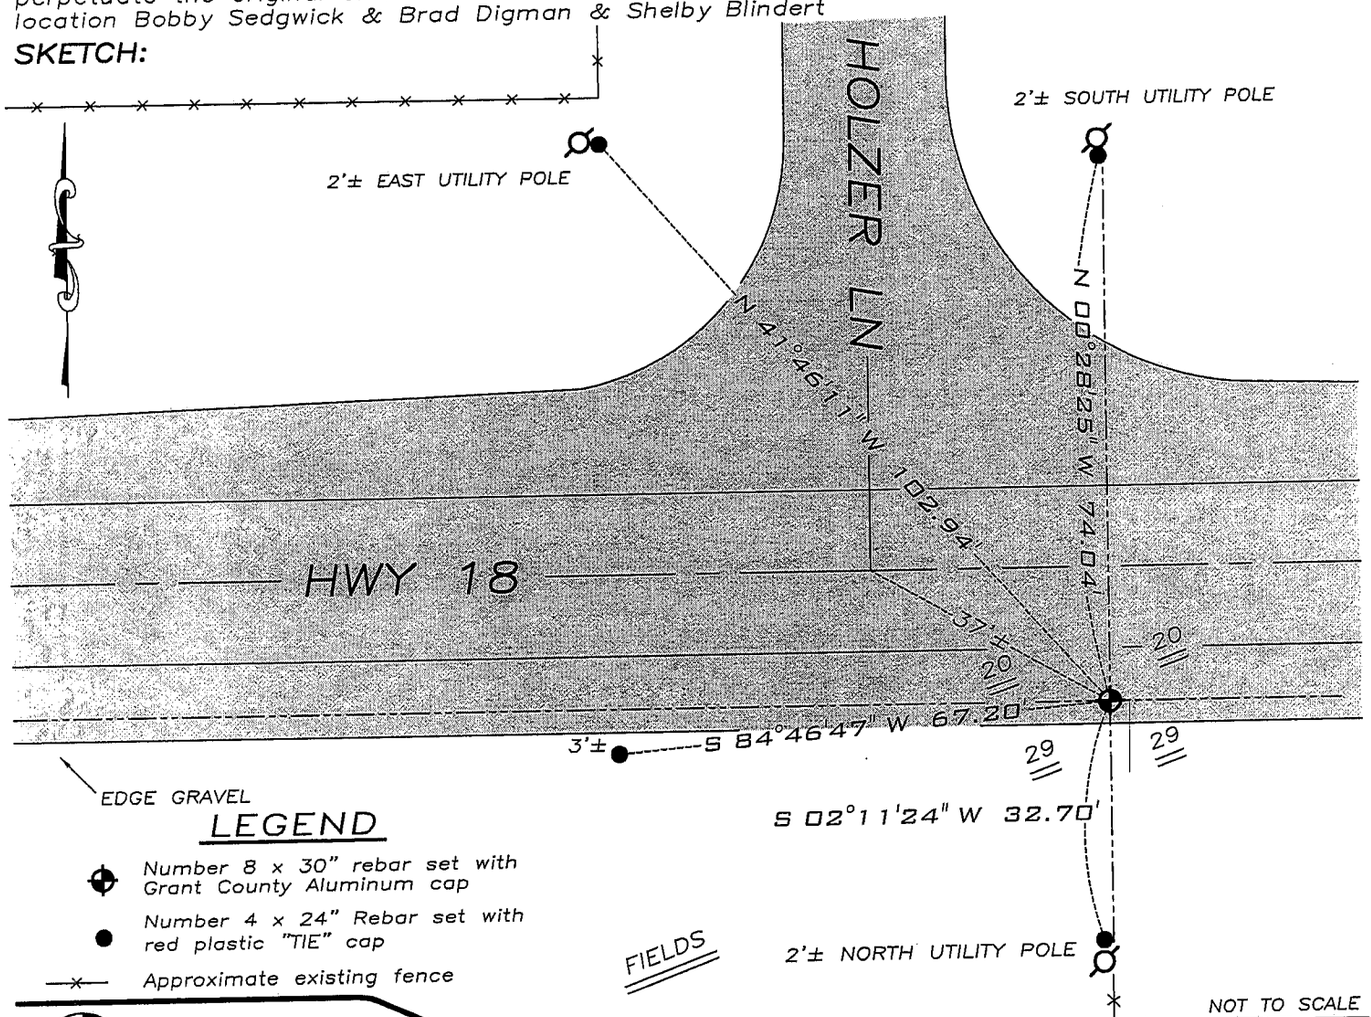

LEGEND

- Number 8 x 30" rebar set with Grant County Aluminum cap
- Number 4 x 24" Rebar set with red plastic "TIE" cap
- Approximate existing fence

NOT TO SCALE

Austin Engineering LLC
4211 HWY 81 E, LANCASTER, WI 53813
PHONE 608-723-6363 FAX 608-723-6702

JOB NUMBER 08S198-KELLEY
FIELDBOOK: TDSR, 2800
G:\GRANTDOT\HWY18
H:\TIE\T6NR1W\90

DRAWN BY: SW AUSTIN
APPROVED: LL AUSTIN

90