U.S. PUBLIC LAND SURVEY MONUMENT RECORD

Section 22, Town 6 North Range 4 West, Town of Mount Hope, Grant County, Wisconsin

CERTIFICATE

I, Larry L. Austin, do hereby certify that the corner location on this record was determined by me and/or under my direct supervision and that this U.S. public land survey monument record is correct and complete to the best of my knowledge and belief.

Larry L. Austin, S-1903 date 7.26.11

WISCONSIN LARRY L. AUSTIN S-1903 LANCASTER WI LAND SURVEYOR

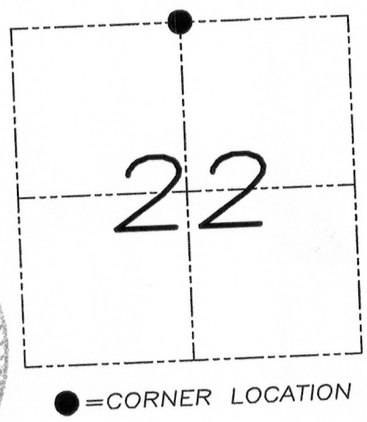

HISTORY OF CORNER

Corner was originally set in 1833 by Harvey Parke. In 1990 Larry Schmit computed a location for the corner but set no monument. No other record of the corner was found.

CORNER EVIDENCE FOUND

I set the corner proportionately between the Northwest and Northeast corners of Section 22. Verified this location using EDM & GPS methods.

DESCRIPTION OF CORNER AND WITNESS MONUMENTS, references and accessories used to perpetuate the original or re-established location of this corner. Witnesses to monument location Bobby Sedgwick & Shane Austin & Shelby Blindert

SKETCH:

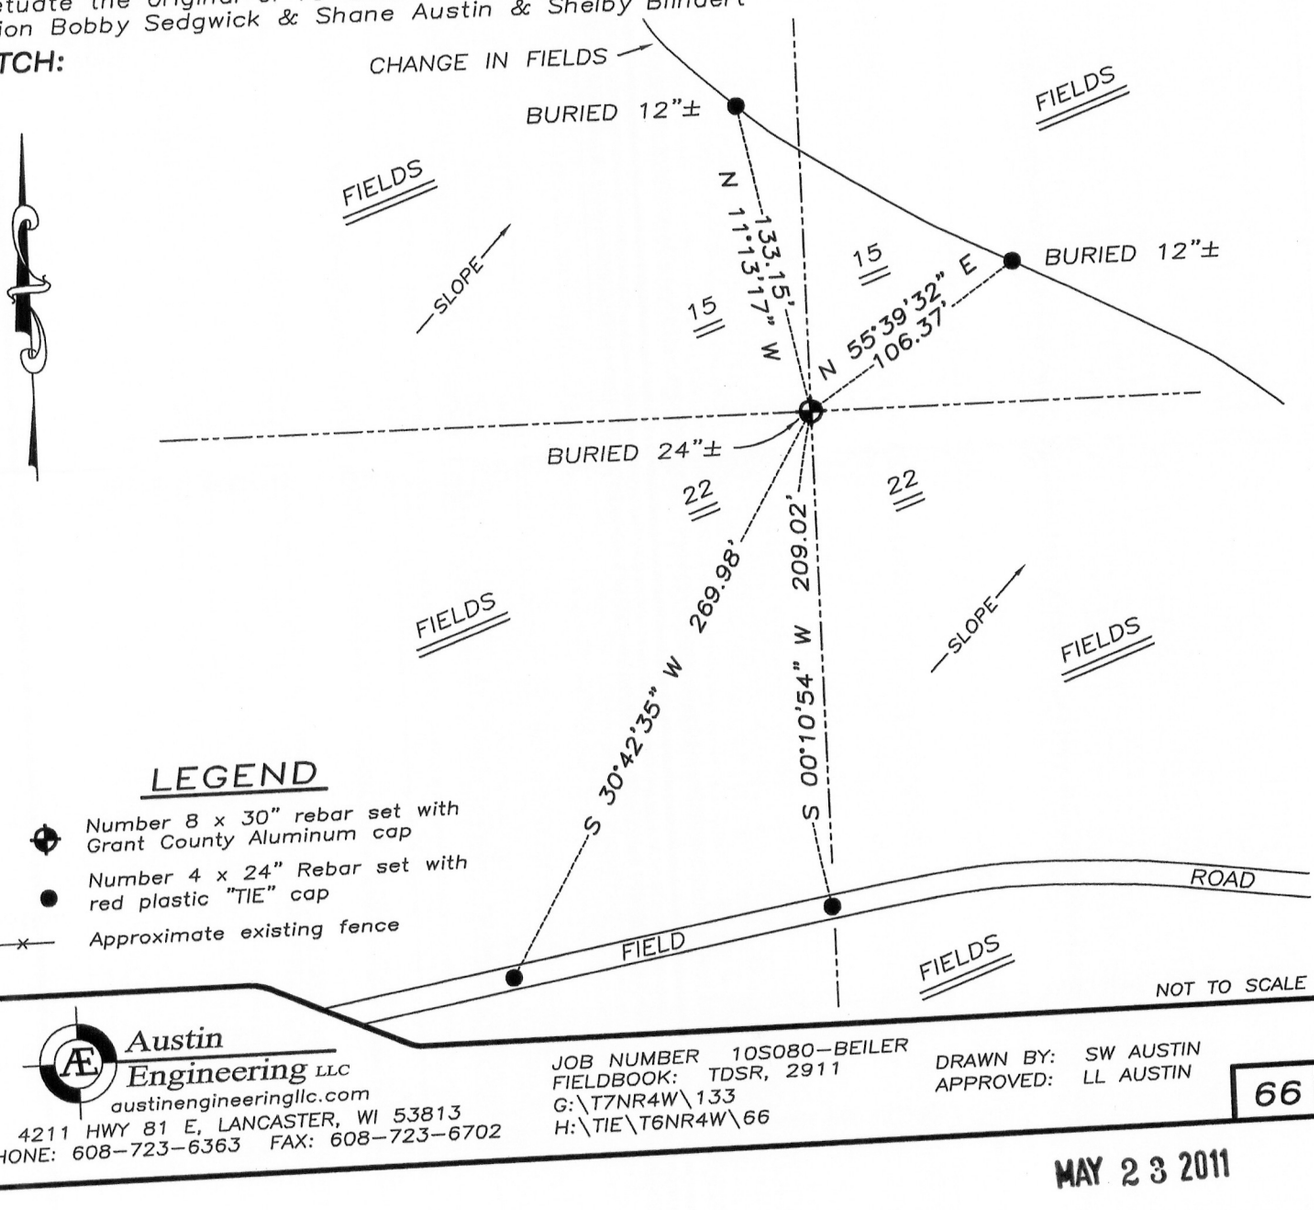

Austin Engineering LLC
austinengineeringllc.com
4211 HWY 81 E, LANCASTER, WI 53813
PHONE: 608-723-6363 FAX: 608-723-6702

JOB NUMBER 10S080-BEILER
FIELDBOOK: TDSR, 2911
G:\T7NR4W\133
H:\TIE\T6NR4W\66

DRAWN BY: SW AUSTIN
APPROVED: LL AUSTIN

66

MAY 23 2011