# U.S. PUBLIC LAND SURVEY MONUMENT RECORD – GRANT COUNTY, WI

## Section 14, Town 6 North Range 4 West, Town of Mt. Hope

CERTIFICATE

I, Larry L. Austin, do hereby certify that the corner location on this record was determined by me and/or under my direct supervision and that this U.S. public land survey monument record is correct and complete to the best of my knowledge and belief.

Dated this 1st day of August, 2005

Larry L. Austin S–1903

WISCONSIN LARRY L. AUSTIN S-1903 LANCASTER WI LAND SURVEYOR

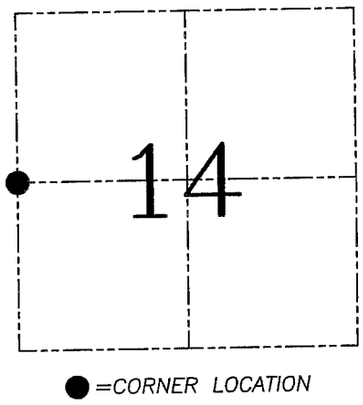


HISTORY OF CORNER ESTABLISHMENT

Corner was originally set in 1833 by Parke. In 1978 Schmit set a 1" iron pipe at this location. No other record of the corner was found.

DESCRIPTION OF CORNER EVIDENCE FOUND

I found the existing 1" iron pipe and accepted it's location after an EDM & GPS traverse of the area.

DESCRIPTION OF CORNER AND WITNESS MONUMENTS, references and accessories used to perpetuate the original or re–established location of this corner. Witnesses to corner location Bobby Sedgwick & Brad Digman & Shane Austin

SKETCH:

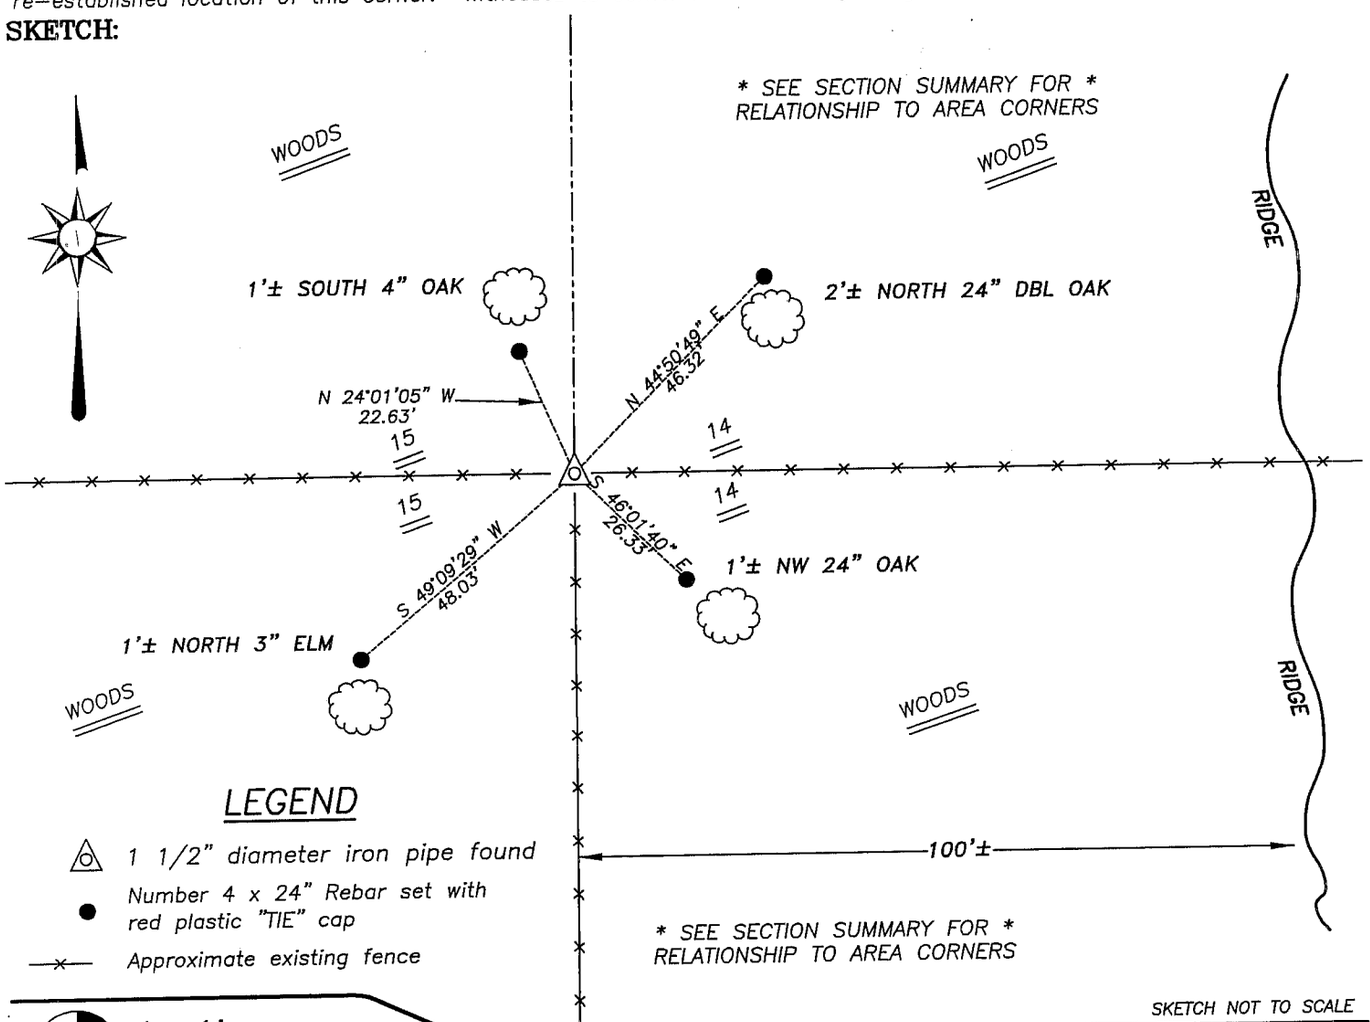


LEGEND

- 1 1/2" diameter iron pipe found
- Number 4 x 24" Rebar set with red plastic "TIE" cap
- Approximate existing fence

SKETCH NOT TO SCALE

Austin Engineering LLC
4211 HWY 81 E, LANCASTER, WI 53813
PHONE 608–723–6363 FAX 608–723–6702

JOB NUMBER: 05s114
FIELDBOOK: TDSR, 2516
G:\T6NR4W\14
H:\TIE\T6NR4W\58

DRAWN BY: BJ HAZEN
APPROVED: LL AUSTIN