U.S. PUBLIC LAND SURVEY MONUMENT RECORD

Section 28, Town 6 North Range 5 West, Town of Patch Grove, Grant County, Wisconsin

CERTIFICATE

I, Larry L. Austin, do hereby certify that the corner location on this record was determined by me and/or under my direct supervision and that this U.S. public land survey monument record is correct and complete to the best of my knowledge and belief.

Larry L. Austin, S-1903 — date 2-18-11

WISCONSIN LARRY L. AUSTIN S-1903 LANCASTER WI LAND SURVEYOR

HISTORY OF CORNER

Corner was originally set in 1832 by Harvey Parke.
No other record of the corner was found.

CORNER EVIDENCE FOUND

I found an existing fence corner and accepted it's location after an EDM and GPS traverse of the area. Verified this location using EDM & GPS methods.

DESCRIPTION OF CORNER AND WITNESS MONUMENTS, references and accessories used to perpetuate the original or reestablished location of this corner. Witnesses to monument location Bobby Sedgwick & Shelby Blindert & Shane Austin

SKETCH:

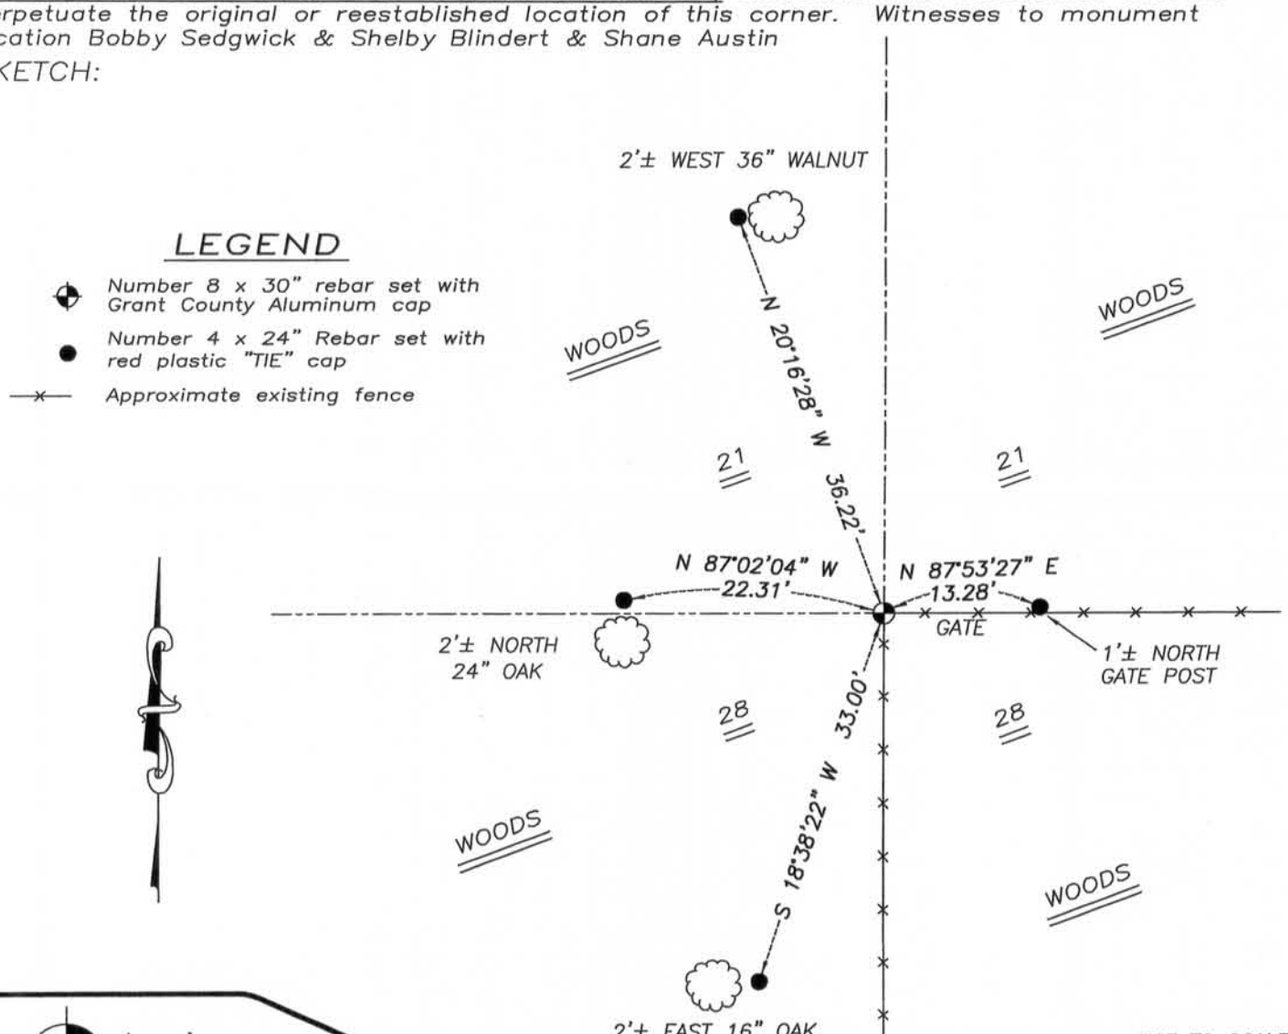

Austin Engineering LLC
austinengineeringllc.com
4211 HWY 81 E, LANCASTER, WI 53813
PHONE: 608-723-6363 FAX: 608-723-6702

JOB NUMBER 10S171-PSZENICZNY
FIELDBOOK: TDSR,
G:\T6NR5W\28
H:\TIE\T6NR5W\88
DRAWN BY: SW AUSTIN
APPROVED: LL AUSTIN

88

FEB 2 3 2011