GRANT COUNTY
CERTIFIED LAND CORNER

CERTIFICATE:

I, LARRY L. AUSTIN, DO HEREBY CERTIFY THAT ON 25th. DAY OF NOVEMBER, 1999, I FOUND NO EVIDENCE OF THE WEST 1/4 CORNER OF SECTION 3, TOWN 7 NORTH, RANGE 1 WEST, OF THE FOURTH PRINCIPAL MERIDIAN, AND I RE-ESTABLISHED SAID CORNER ACCORDING TO THE WISCONSIN STATUTES AS SHOWN AND DESCRIBED HEREON.

DATED THIS 2nd DAY OF NOVEMBER, 1999

LARRY L. AUSTIN S-1903

WISCONSIN
LARRY L. AUSTIN S-1903 LANCASTER WI
LAND SURVEYOR

SEAL

CORNER NUMBER 17

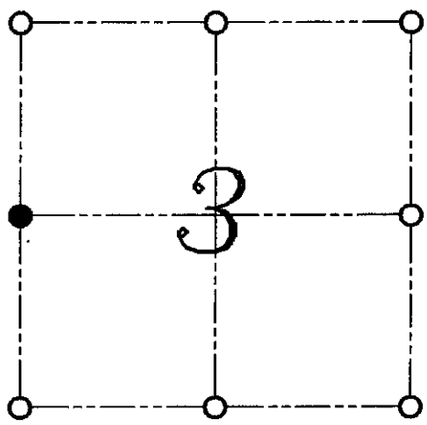

● = CORNER LOCATION

WEST 1/4 CORNER OF SECTION 03, T 7 N R 1 W TOWN OF CASTLE ROCK

HISTORY OF ORIGINAL CORNER ESTABLISHMENT:

CORNER WAS SET IN 1833 BY SIBLEY.
1880 JOEL BARBER ESTABLISHED NEW BEARING TREES.

DESCRIPTION OF CORNER EVIDENCE FOUND:

I FOUND NO EVIDENCE OF THIS LOCATION. I RESET THE CORNER BASED ON PROPORTIONING METHODS ALONG THE WEST LINE OF THE SOUTHWEST 1/4 DUE TO THE EXCESS OF DISTANCE ON THE WEST LINE OF THE NORTHWEST 1/4. VERIFIED THIS LOCATION USING E.D.M. AND G.P.S. METHODS.

DESCRIPTION OF CORNER AND WITNESS MONUMENTS, REFERENCES AND ACCESSORIES USED TO PERPETUATE THE ORIGINAL OR RE-ESTABLISHED LOCATION OF THIS CORNER:
WITNESS TO THE CORNER LOCATION: BOBBY SEDGWICK ; SHELBY BLINDERT

SKETCH:

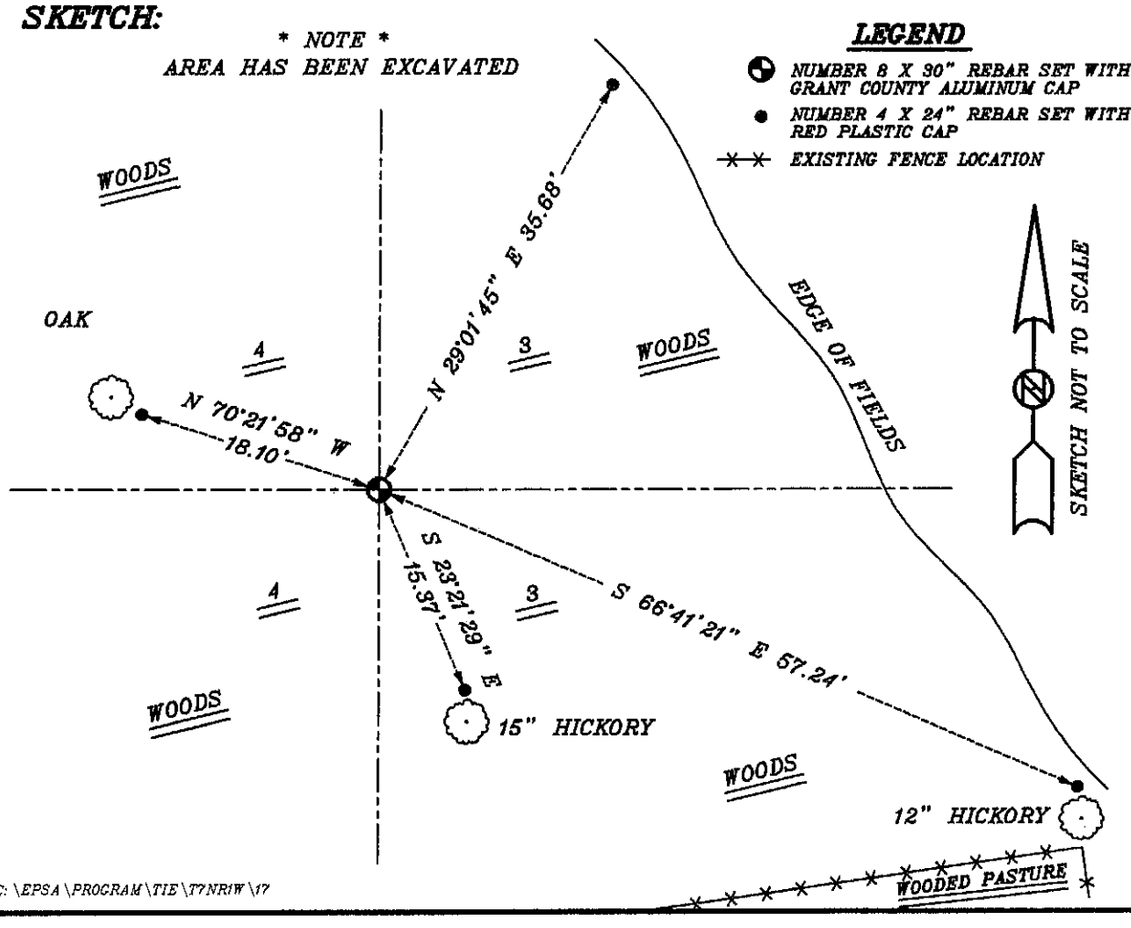

C:\EPSA\PROGRAM\TIE\T7NR1W\17