GRANT COUNTY

Survey Monument Record

Castle Rock Jct

CORNER NO. 112
SECTION 31
TOWN 7 N
RANGE 1 W

TYPE OF MONUMENT Existing 1" Pipe
STATE PLANE COORDINATES: N
E
ELEVATION — M.S.L. DATUM:
THETA ANGLE:
FIELD BOOK:
PAGE

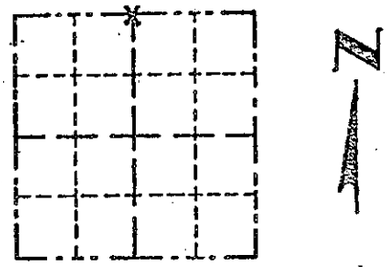

LOCATION
(Indicated by "X")

BASIS FOR MONUMENT LOCATION

(Use reverse side if necessary)

Show info such as: History of corner, with reference to Vol. and pg., dates, surveyor; exact description of monument replaced; if location computed, by taped or EDM traverse; landowner, remarks, etc.

SEAL:

1" pipe found in place surrounded by a pile of rocks and mentioned in previous surveys.

WISCONSIN
BRUCE D. BOWDEN
S-1250
LAND SURVEYOR

CERTIFIED CORRECT
Bruce D Bowden
Registered Land Surveyor
DATE: AUGUST 2, 1983

AUG 8 1983

TIE SKETCH

Show at least three (3) ties and monument

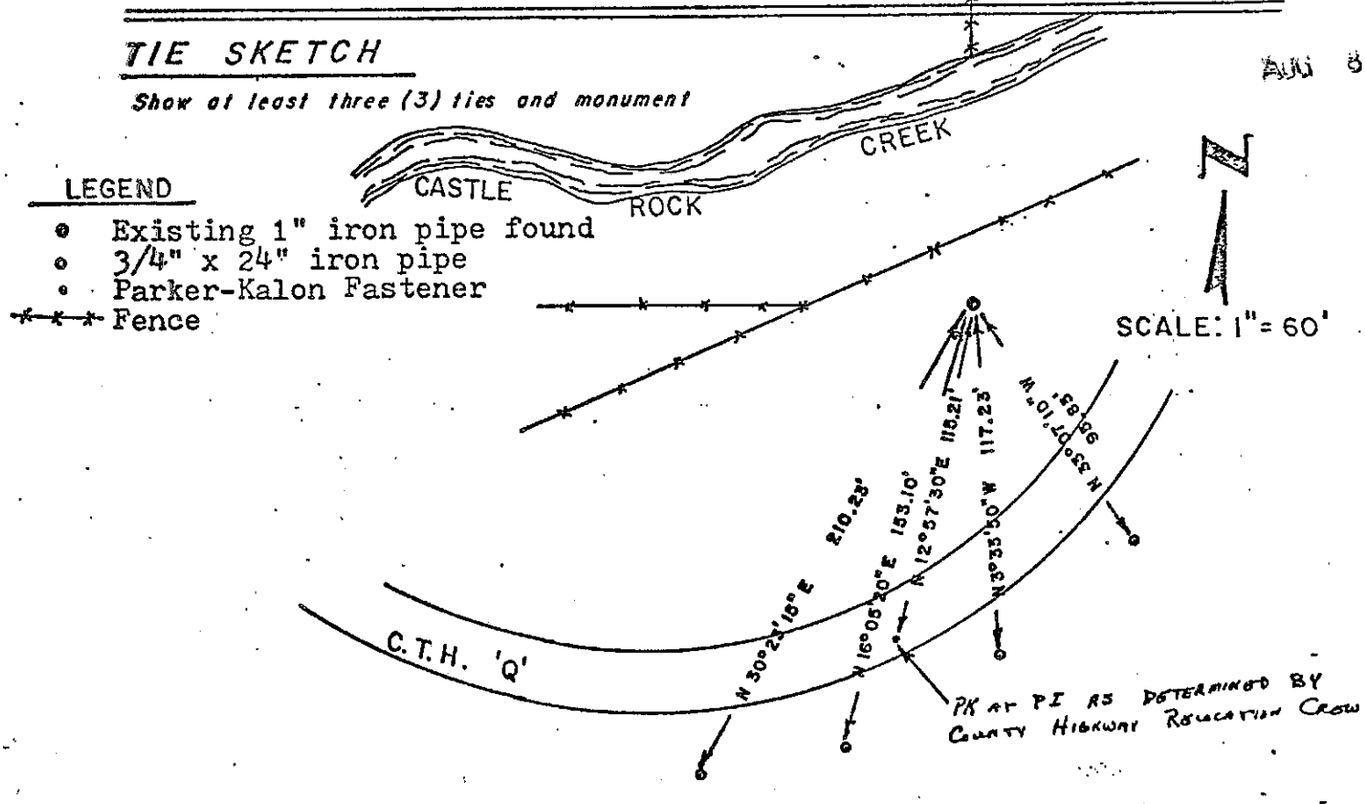

LEGEND
- Existing 1" iron pipe found
- 3/4" x 24" iron pipe
- Parker-Kalon Fastener
- Fence

FORM LC 102

P-19