Survey Monument Record

CORNER NO. SE
SECTION 7
TOWN 7N
RANGE 2W

TYPE OF MONUMENT 3/4" rebar
STATE PLANE COORDINATES: N
E
ELEVATION — M.S.L. DATUM:
THETA ANGLE:
FIELD BOOK: 93-9
PAGE

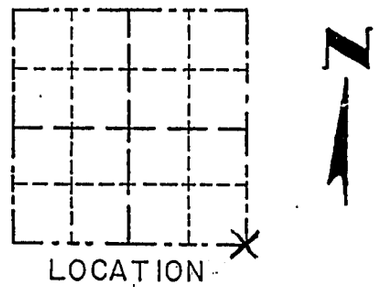

LOCATION
(Indicated by "X")

BASIS FOR MONUMENT LOCATION

(Use reverse side if necessary)

Show info such as: History of corner, with reference to Vol. and pg., dates, surveyor; exact description of monument replaced; if location computed, by taped or EDM traverse; landowner, remarks, etc.

SEAL:

There are no survey records of this corner since the original government record. Ownership records dating back into the 1800's indicate that this corner has been maintained in its current location as well as testimonial evidence of area residents (seniors). Occupational evidence are fences south, East and Northwest. A 3/4" rebar was placed alongside a gnarly old dead oak in a pile of rocks at the corner after an EDM traverse of the area.

CERTIFIED CORRECT
Laurence E. Schmit
Registered Land Surveyor
DATE: 10/20/93

WISCONSIN
LAURENCE E. SCHMIT
S-1312
Dodgeville
Wis.
LAND SURVEYOR

TIE SKETCH

Show at least three (4) ties and monument

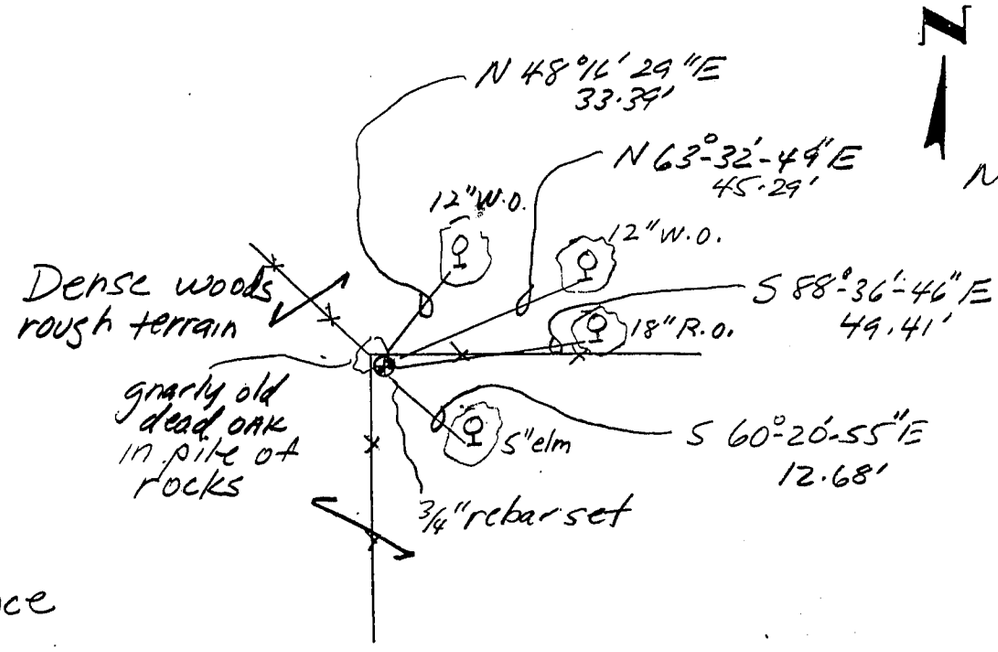

Not to scale

Legend
—×—×— fence
(♀) R.S. Nail in tree