U.S. PUBLIC LAND SURVEY MONUMENT RECORD

(AS REQUIRED BY s.A-E 7.08, WI. ADM. CODE)

HISTORY OF ORIGINAL CORNER ESTABLISHMENT AND SUBSEQUENT RESTORATIONS AND DESCRIPTION OF ANY RECORD, MONUMENT, OCCUPATION, TESTIMONIAL OR OTHER EVIDENCE CONSIDERED

THE CORNER WAS PREVIOUSLY FOUND BY MYSELF ON A SURVEY DATED 5-26-94 AND SUBSEQUENTLY REFERRED TO ON 2 SURVEYS IN SECTION 28 BY LARRY AUSTIN WE REPLACED THE FOUND 3/4"Φ REBAR WITH 7/8"Φ REBAR WITH GRANT CO. ALUM. CAP

COORDINATES ARE ESTABLISHED TO THE CORNER AND WITNESS TIES AS SHOWN BELOW

BEARING REFERENCE AND COORDINATES ARE GRANT COUNTY COORDINATE SYSTEM
NAD 83(91) ENGLISH SYSTEM N 598639.83 E 841429.81

CORNER WAS: (CHECK ALL THAT APPLY)

- ☐ RESTORED THROUGH ACCEPTANCE OF AN OBLITERATED EVIDENCE LOCATION
- ☒ RESTORED THROUGH ACCEPTANCE OF A FOUND PERPETUATED LOCATION CONSIDERED A LOST CONRER AND REESTABLISHED THROUGHT LOST CORNER PROPORTIONATE METHODS (INCLUDE A PLAN VIEW DRAWING SHOWING BEARING & DISTANCE TO OTHER PUBLIC LAND SURVEY CORNERS
- ☐ USED FOR PROPORTIONING AND DETERMINING THE CORNER LOCATION)
- ☐ RESTORED OR REESTABLISHED IN A LOCATION THAT DIFFERS FROM A PREVIOUS RESTORATION OR REESTABLISHMENT (INCLUDE A PLAN VIEW DRAWING AND INDICATE WHAT WAS SET AND/OR FOUND)

Describe the monument and accessories used to perpetuate the location of the corner. (include a plan view drawing and indicated what was set and/or found)

LEGEND:

- △ SET 5/8"Φ REBAR TIE
- ☐ FOUND STONE MONUMENT
- ⊡ FOUND REBAR WITH LAF. CO. ALUM CAP
- ⊡ SET 7/8"X24" REBAR WITH GRANT CO. ALUM CAP
- ( ) RECORED AS
- ⊗ FD. RING SHANK NAIL
- —x—x— FENCE
- ▲ FOUND 1" IRON PIPE

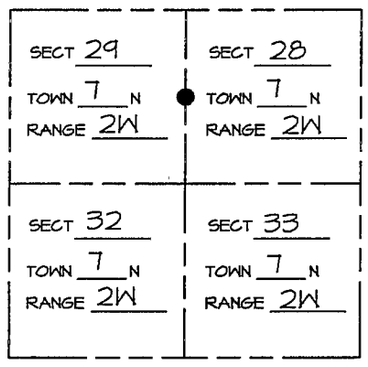

● = LOCATION OF CORNER

THE W1/4 COR. OF SECT 28 T 7 N, R 2W

THE ____ COR. OF SECT ____ T ___ N, R ____

THE E1/4 COR. OF SECT 29 T 7 N, R 2W

THE ____ COR. OF SECT ____ T ___ N, R ____

GRANT COUNTY, WISCONSIN

JOB ID: 055-152 BOOK #: 2005-3 P.12

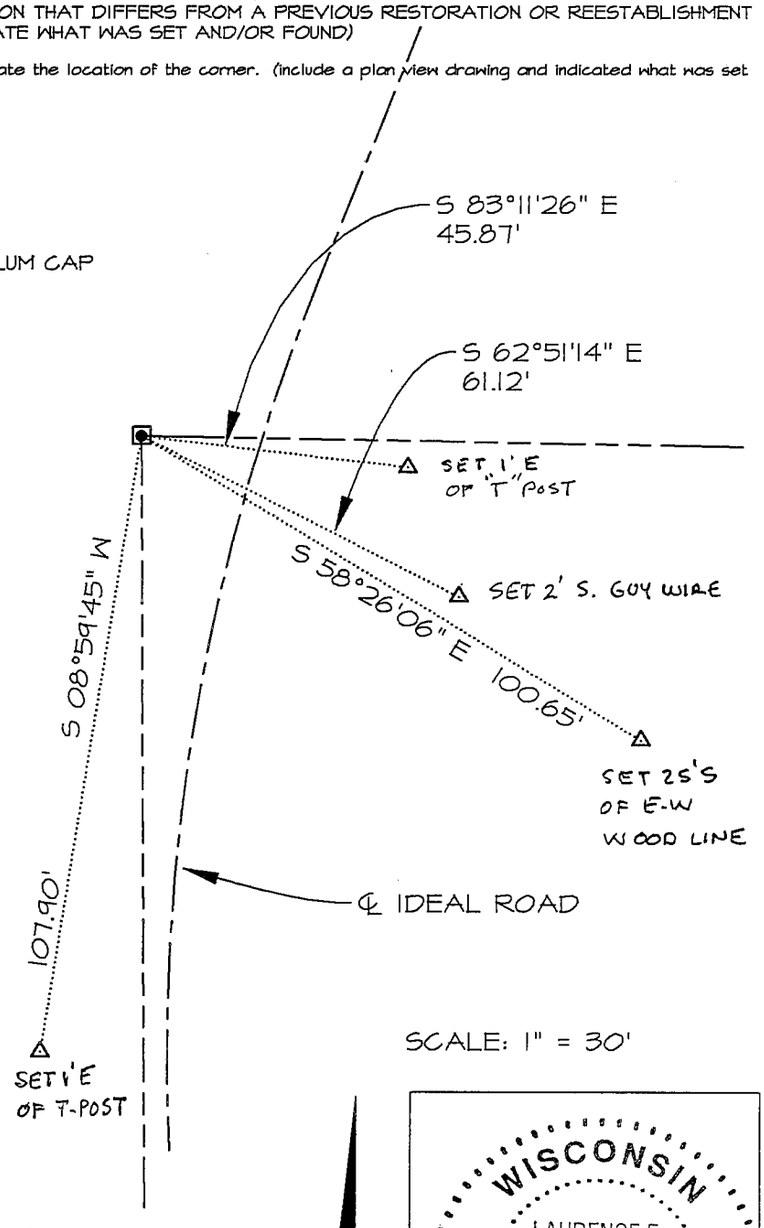

SCALE: 1" = 30'

N

-NTS-

I, LAURENCE E SCHMIT CERTIFY THAT THE CORNER LOCATION SHOWN ON THIS RECORD WAS DETERMINED BY ME OR UNDER MY DIRECTION AND CONTROL AND THAT THIS U.S. PUBLIC LAND SURVEY MONUMENT RECORD IS CORRECT AND COMPLETE TO THE BEST OF MY KNOWLEDGE AND BELIEF.

Laurence E Schmit 9-20-05

SIGNATURE DATE:

WISCONSIN
LAURENCE E. SCHMIT
S-1312
DODGEVILLE
WIS.
LAND SURVEYOR

LAND SURVEYORS SEAL

INDEX NUMBER 96