GRANT COUNTY
CERTIFIED LAND CORNER

CORNER NUMBER 119

CERTIFICATE:

I, Larry L. Austin, do hereby certify that on the 17th day of March, 2000, I found no evidence of the West 1/4 corner of Section 36, Town 7 North, Range 2 West, of the 4th Principal Meridian, and I re-established said corner according to the Wisconsin statutes as shown and described hereon.

Dated this 31st day of March, 2000

Larry L. Austin S-1903

WISCONSIN
LARRY L. AUSTIN S-1903 LANCASTER WI
LAND SURVEYOR

SEAL

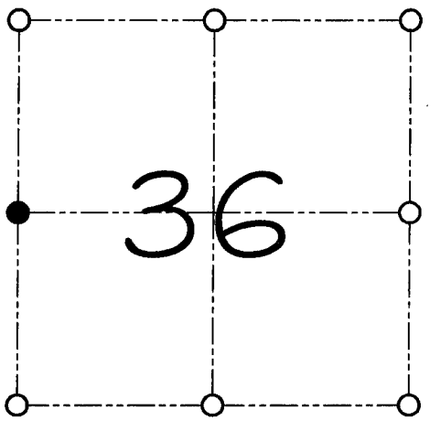

● = CORNER LOCATION

WEST 1/4 CORNER OF
SECTION 36, T 7 N R 2 W
TOWN OF HICKORY GROVE

HISTORY OF ORIGINAL CORNER ESTABLISHMENT:

Corner was originally set in 1832 by Harvey Parke.
No other record of the corner was found.

DESCRIPTION OF CORNER EVIDENCE FOUND:

I found no evidence to the location of the corner.
I set the corner at a proportional distance between the Northwest and Southwest corners of Section 36. Verified this location using E.D.M. & G.P.S. methods.

DESCRIPTION OF CORNER AND WITNESS MONUMENTS, references and accessories used to perpetuate the original or re-established location of this corner

WITNESS TO THE CORNER LOCATION: CODY AUSTIN & SHANE AUSTIN

SKETCH:

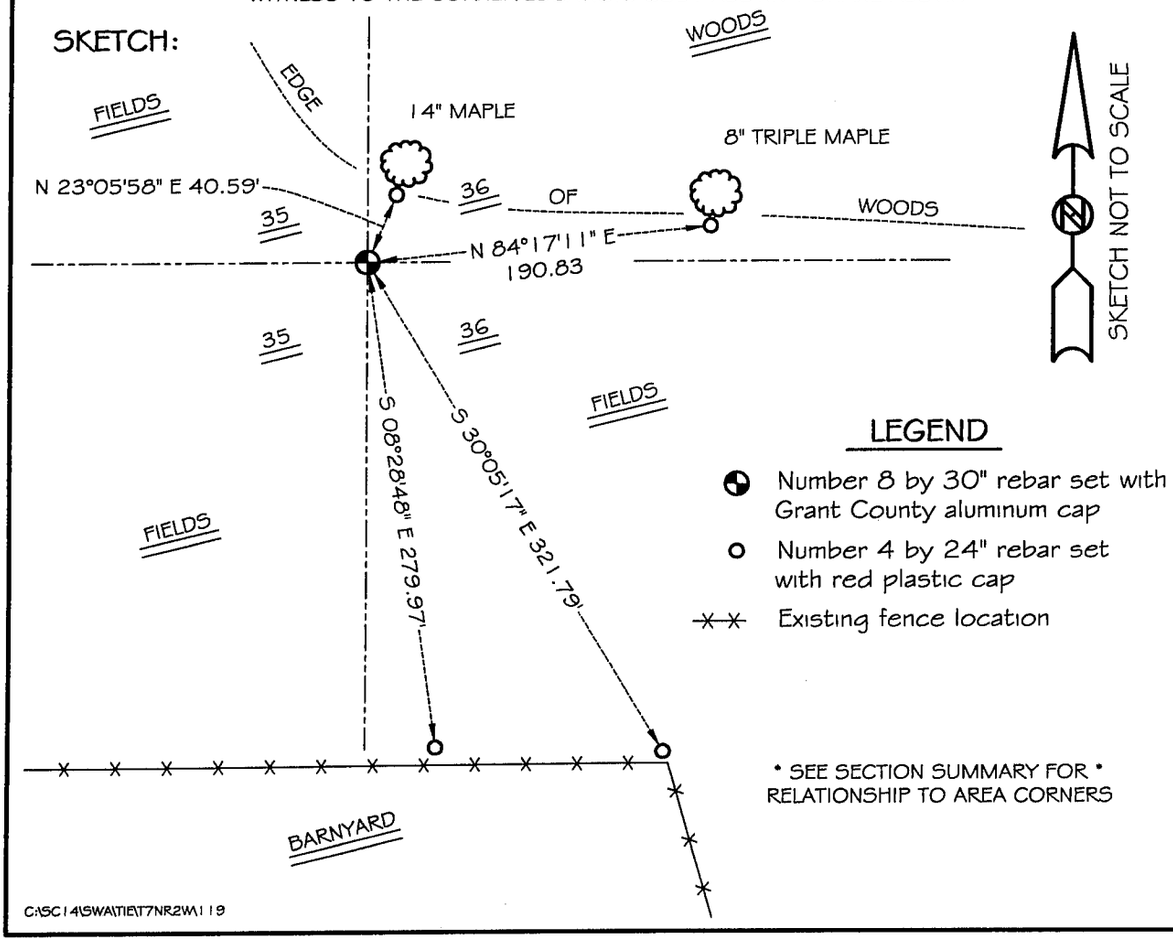

LEGEND

- ◓ Number 8 by 30" rebar set with Grant County aluminum cap
- o Number 4 by 24" rebar set with red plastic cap
- -x-x- Existing fence location

* SEE SECTION SUMMARY FOR * RELATIONSHIP TO AREA CORNERS

C:\SC14\SWA\TIE\T7NR2W\119

119