MAY 25 1990

GRANT COUNTY

GOVERNMENT CORNER RECORD

N W CORNER, SECTION 19, TOWNSHIP 7 NORTH, RANGE 2 ~~EAST~~ - WEST,
TOWN, ~~CITY OR VILLAGE~~ OF HICKORY GROVE, RICHLAND CO.

TYPE OF MONUMENT: 3/4" IRON ROD FOUND ELEVATION - M.S.L. DATUM _____

STATE PLANE COORDINATES: N _____

WISCONSIN SOUTH ZONE E _____

WITNESSES TO CORNER LOCATION

SEAN M. WALSH

PATRICK J. DEDERICH

SECTION 19, T 7 N, R 2 ~~E~~ W
TOWN OF HICKORY GROVE

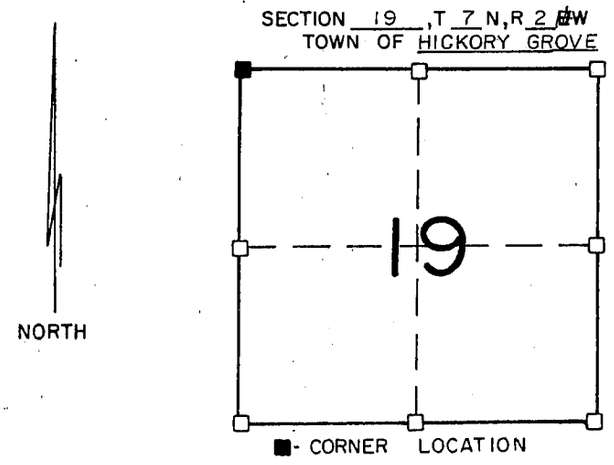

TIE SKETCH
(SHOW ALL HELPFUL FEATURES)

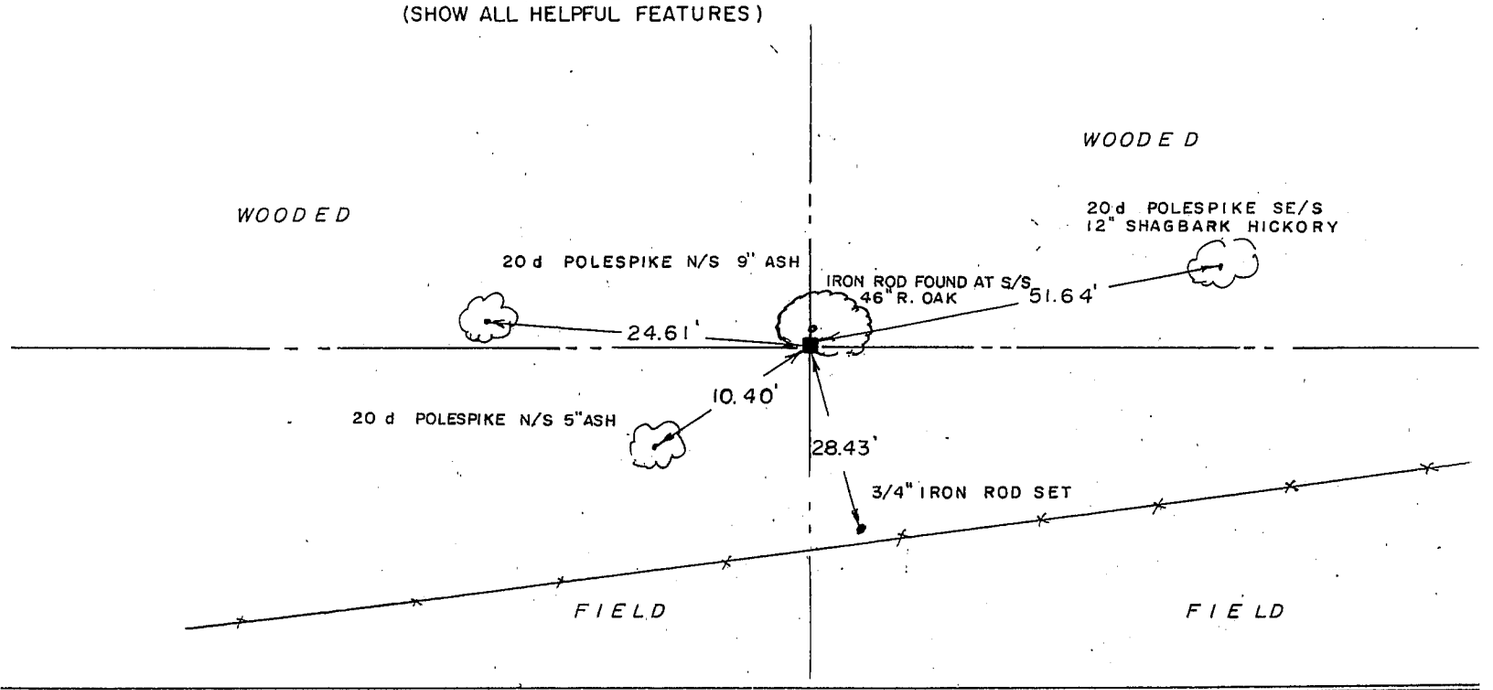

SURVEYOR'S CERTIFICATE

STATE OF WISCONSIN) SS
RICHLAND COUNTY)

SEAL S-1454

I, Matthew J. Janiak, DO HEREBY CERTIFY THAT the above corner has been accepted and perpetuated under my direction and supervision in accordance with the information contained hereon and that this information is correct and true to the best of my information, knowledge and belief. A 3/4 inch iron bar was found at the above location, this fit very well with the west line of section 19.

WISCONSIN
MATTHEW J. JANIAK
S-1454
RICHLAND CENTER, WI
LAND SURVEYOR

DATED THIS 16TH DAY OF May, 19 90

REGISTERED LAND SURVEYOR

CORNER CODE P 73

(OVER)