GRANT COUNTY
CERTIFIED LAND CORNER

CORNER NUMBER 92

CERTIFICATE:

I, Larry L. Austin, do hereby certify that on the 22nd day of June, 2000, I found no evidence of the North 1/4 corner of Section 30, Town 7 North, Range 4 West, of the 4th Principal Meridian, and I re-established said corner according to the Wisconsin statutes as shown and described hereon.

Dated this 27th day of December, 2000

Larry L. Austin S-1903

WISCONSIN
LARRY L.
AUSTIN
S-1903
LANCASTER
WI
LAND SURVEYOR

SEAL

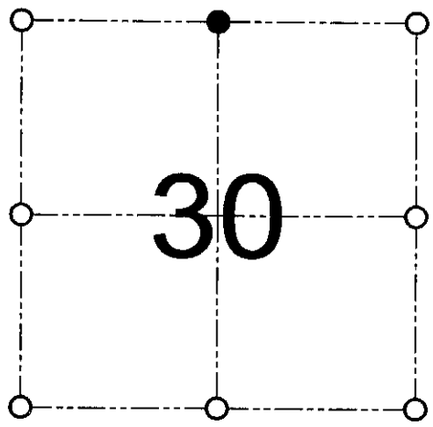

● = CORNER LOCATION

NORTH 1/4 CORNER OF
SECTION 30, T 7 N R 4 W
TOWN OF WOODMAN

HISTORY OF ORIGINAL CORNER ESTABLISHMENT:

Corner was originally set in 1833 by Harvey Parke.
No other record of the corner was found

DESCRIPTION OF CORNER EVIDENCE FOUND:

I found no evidence to the location of the corner. I reset the corner proportionately between the Northwest and Northeast corners of this section. Verified this location using EDM & GPS methods.

DESCRIPTION OF CORNER AND WITNESS MONUMENTS, references and accessories used to perpetuate the original or re-established location of this corner

WITNESS TO THE CORNER LOCATION: SHANE AUSTIN & SHELBY BLINDERT & BOBBY SEDGWICK

SKETCH:

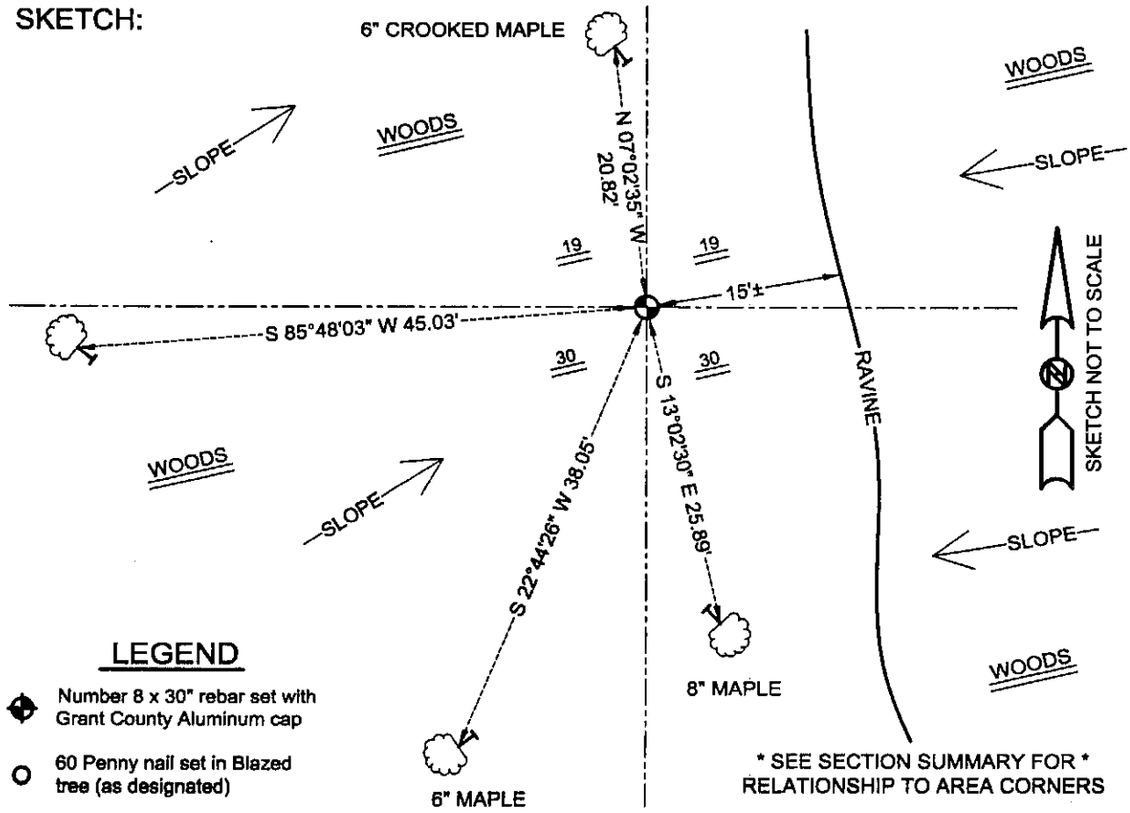

LEGEND

- ✦ Number 8 x 30" rebar set with Grant County Aluminum cap
- ○ 60 Penny nail set in Blazed tree (as designated)

* SEE SECTION SUMMARY FOR *
RELATIONSHIP TO AREA CORNERS

AUSTIN ENGINEERING, LLC
4211 HWY 81 E, LANCASTER, WI 53813
PHONE 608-723-6363 FAX 608-723-6702

FIELDBOOK: SDR33, 2006
G:\T7NR4W\32A
C:\SC14\SWA\TIE\T7NR4W\92

DRAWN BY: SW AUSTIN
APPROVED: LL AUSTIN
CREW: BS – SB – SA.