FORM NO. 985-A

H.C. Miller Company

RECORD OF CORNER MONUMENTATION

NORTH QUARTER CORNER SECTION 4 TOWNSHIP 7 N RANGE 3 W

GRANT COUNTY, WISCONSIN

STATE PLANE COORDINATES OF _____

(Y) NORTH _____ ELEVATION _____

(X) EAST _____

HORIZONTAL DATUM: WISCONSIN STATE PLANE COORDINATE SYSTEM, SOUTH ZONE

SKETCH OF CORNER REFERENCE TIES

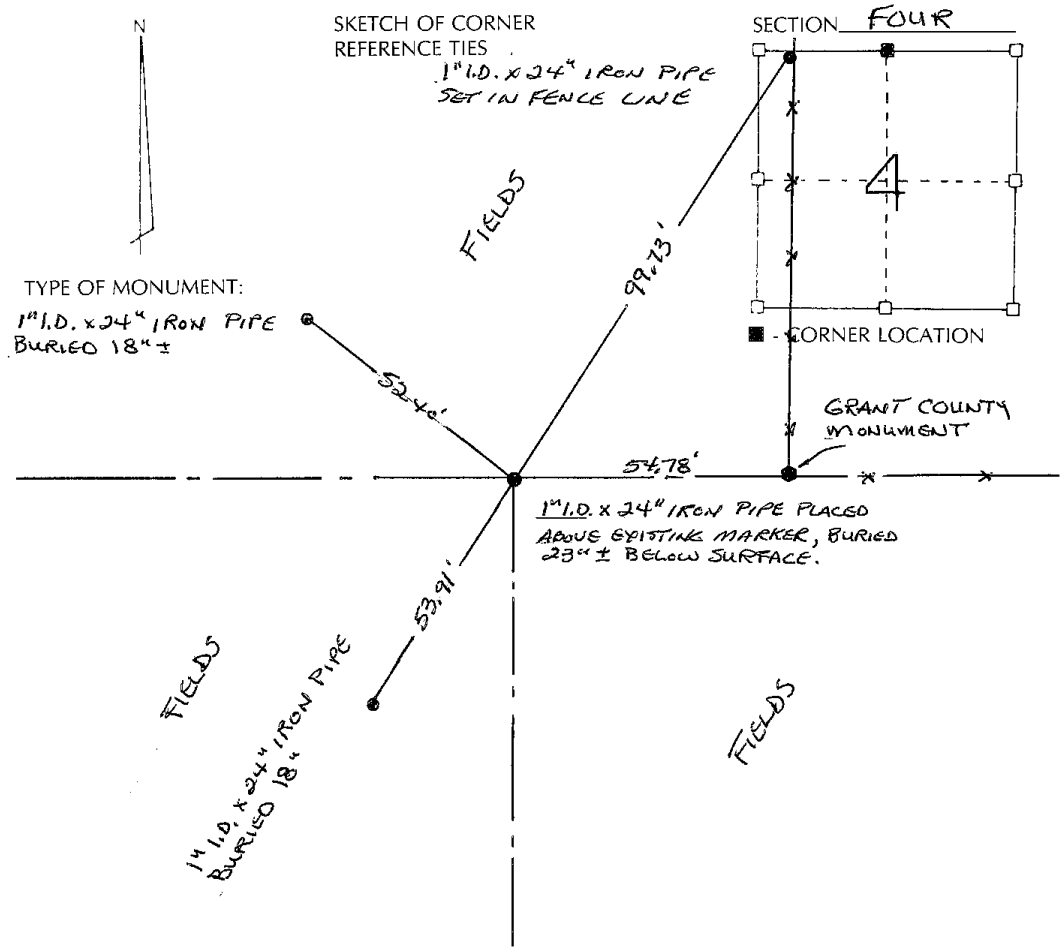

SURVEYOR'S CERTIFICATE
(STATE OF WISCONSIN)

I HEREBY CERTIFY THAT DURING THE PERFORMANCE OF A SURVEY FOR BERNIE MISCHEL ON OR ABOUT NOVEMBER 2002, WE DID LOCATE AN IRON MARKER AT THIS CORNER, BURIED APPROXIMATELY FOUR FEET BELOW THE SURFACE. WE PLACED A 1" INSIDE DIAMETER x 24" IRON PIPE DIRECTLY ABOVE THIS MARKER (FOR EASIER ACCESS) WHICH IS BURIED APPROXIMATELY TWO FEET BELOW THE SURFACE. THE ABOVE MARKERS WERE SET FOR THE PURPOSE OF PERPETUATION.

DATED THIS 20th DAY OF DECEMBER 2004

Terry L. Cornell

REGISTERED LAND SURVEYOR
S-1905

WISCONSIN
TERRY L. CORNELL
S 1905
RICHLAND CENTER, WI
LAND SURVEYOR