CRAIG HARDY

GRANT COUNTY
CERTIFIED LAND CORNER

CORNER NUMBER 93

CERTIFICATE:

I, Larry L. Austin, do hereby certify that on the 24th day of August, 2000, I found no evidence of the Southwest corner of Section 19, Town 8 North, Range 2 West, of the 4th Principal Meridian, and I re-established said corner according to the Wisconsin statutes as shown and described hereon.

Dated this 2nd day of February, 2001

Larry L. Austin S-1903

WISCONSIN
LARRY L. AUSTIN S-1903 LANCASTER WI
LAND SURVEYOR

SEAL

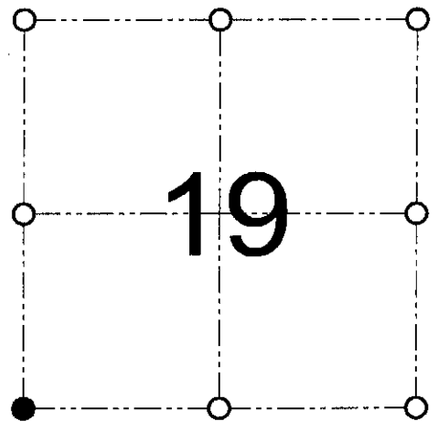

● = CORNER LOCATION

SOUTHWEST CORNER OF
SECTION 19, T 8 N R 2 W
TOWN OF WATTERSTOWN

HISTORY OF ORIGINAL CORNER ESTABLISHMENT:

Corner was originally set in 1833 by Harvey Parke
No other record of the corner was found.

DESCRIPTION OF CORNER EVIDENCE FOUND:

Walsh set the Southeast corner of Section 24, T8N R3W. I set the Southwest corner of Section 19 at the recorded offset from the Southeast corner of Section 24. Verified this location using EDM & GPS methods.

DESCRIPTION OF CORNER AND WITNESS MONUMENTS, references and accessories used to perpetuate the original or re-established location of this corner

WITNESS TO THE CORNER LOCATION: SHELBY BLINDERT & BOBBY SEDGWICK

SKETCH:

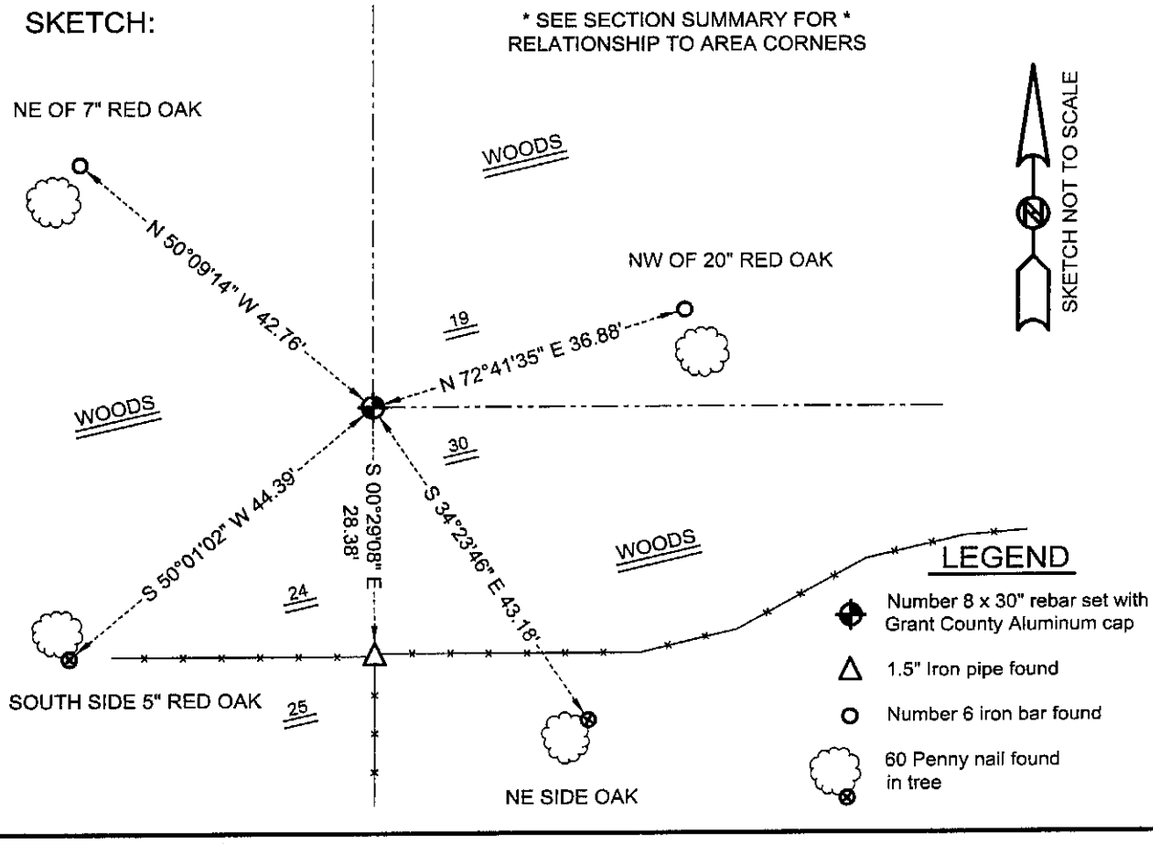

AUSTIN ENGINEERING, LLC
4211 HWY 81 E, LANCASTER, WI 53813
PHONE 608-723-6363 FAX 608-723-6702

FIELDBOOK: SDR33, 2027
G:\T8NR2W\19
C:\SC14\SWA\TIE\T8NR2W\93

DRAWN BY: SW AUSTIN
APPROVED: LL AUSTIN
CREW: BS - SB - SA - TF